

Addendum # 3 Bid Opportunity: 25-7706-RFT - Glenview Park Secondary School Elevator and Science Laboratory Renovation

Closing Date: Monday, April 7, 2025 2:00 PM

The following issued by the Board shall form part of the Bid / Proposal Solicitation document. The revisions and additions noted herein along with any attachments shall be read in conjunction with all other related documents. This Addendum shall, take precedence over the previously issued documents where differences occur. Receipt of this addendum must be acknowledged in the Bidding System, bids&tenders.

If you have already submitted a Bid / Proposal, it will be automatically withdrawn as a result of this addendum. You must resubmit the Bid / Proposal acknowledging all addenda and revising your Bid / Proposal to comply with all addenda.

CLARIFICATION:

Refer to attached Addendum 03 prepared by DEI Consulting Engineering dated April 1, 2025 for all required mechanical and electrical changes.

END OF ADDENDUM



Tel: 519-725-3555 www.deiassociates.ca

April 1, 2025

Client: ABA Architects Inc.

101 Randall Drive, Unit B Waterloo, ON N2V 1C5

RE: Glenview Park Secondary School

Elevator & Science Laboratory Renovation

Cambridge, ON

Job #: 24162

Attn: Anne Ceballo, Architectural Project Manager

ADDENDUM 03

MECHANICAL

Item 1

- 1.0 Reference Drawing M1.1 and Attached Sketches AD03-M01 and AD03-M02
 - .1 Revise Custom Indoor Air Handling Unit Schedule (Phase 2), as per attached sketch AD03-M01.
 - .2 In Custom Indoor Air Handling Unit Schedule (Phase 2), add Haakon as base-bid manufacturer. Daikin shall be listed as an acceptable manufacturer.
 - .3 In Custom Indoor Air Handling Unit Schedule (Phase 2), add Envent as an acceptable manufacturer.
 - .4 In Custom Indoor Air Handling Unit Schedule (Phase 2), add Engineered Air as an acceptable manufacturer.
 - .5 In Pump Schedule, remove requirement for remote variable frequency drive.
 - .6 In Fan Schedule (Phase 1), revise 'EF-8' as per attached sketch AD03-M02.

Item 2

- 2.0 Reference Drawing M1.2 and Attached Sketch AD03-M03
 - .1 Revise HVAC-5 Unit Detail, as per attached sketch AD03-M03. All existing/new services shall be adjusted to suit revised unit layout.
 - .2 For clarification, maximum HVAC-5 unit dimensions shall be:
 - .1 Length: 10,150 mm (max.)
 - .2 Width: 2,925 mm (max.)
 - .3 Height: 2,000 mm(max.)
 - .3 For clarification, HVAC-5 to be placed on 100 mm high concrete housekeeping pad. Unit manufacturer to provide unit base rail height to accommodate adequate condensate trap height/clearance.

ELECTRICAL

Item 1

- 1.0 Reference Attached Reissued Drawing E103
 - .1 Equipment wiring schedule updated.



Item 2

- 2.0 Reference Attached Reissued Drawing E304
 - .1 HVAC supply fan (HVAC-5-SF) has been deleted as per attached reissued drawing E304.
 - .2 Two HVAC return/exhaust fan (HVAC-5-EF) have been deleted as per attached reissued drawing E304.
 - .3 HVAC energy recovery wheel (HVAC-ERW) has been deleted as per attached reissued drawing E304.
 - .4 HVAC unit controller (HVAC-5-UC) has been deleted as per attached reissued drawing E304.
 - .5 Add 208V 3PH power for indoor HVAC unit (HVAC-5) as per attached reissued drawing E304.
 - .6 Add 120V 1PH power for marine lights as per attached reissued drawing E304.

Item 3

- 3.0 Reference Attached Reissued Drawing E401
 - .1 Update distribution riser diagram as per attached reissued drawing E401.

Item 4

- 4.0 Reference Attached Reissued Drawing E402
 - Panel schedule Panel 'MP' updated as per attached reissued drawing E402.

Steve Oatley

Lead Designer, Partner

24162 Addendum 03 (M&E-Various)(reissued dwgs, sketches) Apr 1 25 so/aaa/mpd

CUSTOM INDOOR AIR HANDLING UNIT SCHEDULE (PHASE 2)

	_				Supply Air	Fan L	Data					Exhai	ust Air f	an Data					COC	LING					HEA
Item	Туре	Service	Capacity	Şize	Drive	ESP	Voltage	MCA	MOC	_P Capacit	y Şize	Drive	ESP	Voltage	Medium	Coil	Sens.Cap.		Rows	.Ent	LVG	Face Vel.	PD. Air	Medium	Capacity
		3011100	cfm ,		Dillo	in wo	·onage	111071	WOO	<u>cfm</u>	hp	Dillo	in wc	ronago		Туре	MBH	MBH	Fins/in.	db/wb	db/wb	fpm	in.		MBH
HVAC-5	INDOOR BUILT UP AIR HANDLING UNIT	CLASSROOM ADDITION	13,000	2 © 1	VARIABLE REQUENCY DRIVE	1.25	208/3/60	118	125	15,000	2 © 7.5	DIRECT DRIV	2 © 1.0	208/3/60	R410A	DX	453	504	8/8	80/66	53/51	495	0.95	WATER	789

GENERAL NOTES:


- ACCEPTABLE MANUFACTURERS: HAAKON, DAIKIN, AAON, ENVENT, ENGINEERED AIR
 UNIT SHIPPED IN SECTIONS TO STORAGE FACILITY, THEN TO STILL DOKING.
- PHASE 2 CONSTRUCTION. REFER TO MECHANICAL CASH ALLOWANCES.
- DOUBLE WALL CONSTRUCTION C/W 2" (50mm) R-13 FOAM INSULATION & PERMATECTOR FINISH.
- CORROSION RESISTANT FASTENERS.
 SOLID UNDERFLOOR LINER FACTOR PAINTED TO MATCH UNIT CASING FINISH.
- HINGED ACCESS DOORS.
- FACTORY WIRED NON FUSED DISCONNECT.
 2" (50mm) MERV 13 FILTERS (SUPPLY AIRSTREAM).

- 2" (50mm) MERV 8 FILTERS (OUTDOOR &
- LOW LEAKAGE OUTDOOR AIR DAMPER (THER
- MOTORIZED RELIEF DAMPER, SPRING RETURN SHALL FAIL CLOSED).

											*ESP IS	S EXTERNAL TO THE CABINET
Capacity MBH		LAT db	Flow (gpm)	Туре	Model	Heating Capacity	ECOVERY Cooling Capacity (MBH) 8 88 db/75 wb	PD. Air in.	Manufacturer	Model	Weight (lbs) (approx.)	Remarks
789	40	160	82	SEGMENTED WHEEL		471	197	0.66	HAAKON	AIRPAK	13300±	C/W SEGMENTED ENERGY RECOVERY WHEEL, SUPPLY VFD, DIRECT DRIVE RETURN FAN ECM MOTORS, WHICH SEED COOKING, 200mm HIGH BASE. UNIT SHALL HAVE A MINIMUM OF 2 REFRIGERATION CIRCUITS.
	MALLY B	ROKEN)	EAMS). (3cfm/ft2 DAMPER (- F - S	CONTROLS CON	TE PACKAGE (ALL ONTRACTOR). EATING COIL, REFF UNIT TO VRV/VRF LEAK DETECTION.	RIGERANT AIR SO	T COIL, HOT G		1	UNIT SHALL HAVE A MINIMUM OF Z REPRIGERATION CIRCUITS.

FAN	SCHEDULE (P	HASE	1)					CAPACITY INDICATED ON SCHEDULE REFER TO SPECIFICATION FOR CONSTRUCTION STANDARDS, ACCESSORIES AND ADDITIONAL INFORMATION.
Item	Туре	Capacity cfm	ESP in wc	Fan Speed rpm	hp	Motor Voltage	Acceptable Manufacturer	Description
EF-5	ROOF UPBLAST EXHAUST FAN (CHEMISTRY)	1200	0.375	1375	1/4	120/1/60	PENN BARRY 12BH	SPUN ALUMINUM MOTOR COVER & FAN SHROUD, UPBLAST, W/BELT DRIVE CENTRIFUGAL BACKWARD INCLINED FAN, GALV BIRD SCREEN, 24" HIGH INSULATED ROOF CURB, & BACKDRAFT DAMPER
EF-6	ROOF UPBLAST EXHAUST FAN (BIOLOGY)	1200	0.375	1375	1/4	120/1/60	PENN BARRY 12BH	SPUN ALUMINUM MOTOR COVER & FAN SHROUD, UPBLAST, W/BELT DRIVE CENTRIFUGAL BACKWARD INCLINED FAN, GALV BIRD SCREEN, 24" HIGH INSULATED ROOF CURB, & BACKDRAFT DAMPER
EF-7	ROOF UPBLAST EXHAUST FAN (FUME HOOD)	800	1.0	3135	3/4	208/3/60	PENN BARRY VPLUME 090-6	CONNECT TO FUMEHOOD. SPUN ALUMINUM MOTOR COVER & FAN SHROUD, UPBLAST, W/BELT DRIVE FAN, GALV BIRD SCREEN, 24" HIGH INSULATED ROOF CURB, & BACKDRAFT DAMPER
EF-8	INLINE DUCT MOUNTED EXHAUST	450	0.25	1550	Fhp	120/1/60	PENN BARRY Z10H	C/W VIBRATION ISOLATION HANGERS. REVERSE—ACTING THERMOSTAT BY ELECTRICAL DIVISION

- GENERAL FAN NOTES:
 1. ACCEPTABLE MANUFACTURERS: GREENHECK, PENN-BARRY, COOK, CARNES, ACME, TWIN CITY, JENCO, BUFFALO.
 2. PROVIDE 24" TALL PREFABRICATED, INSULATED ROOF CURB FOR ALL ROOF MOUNTED FANS.

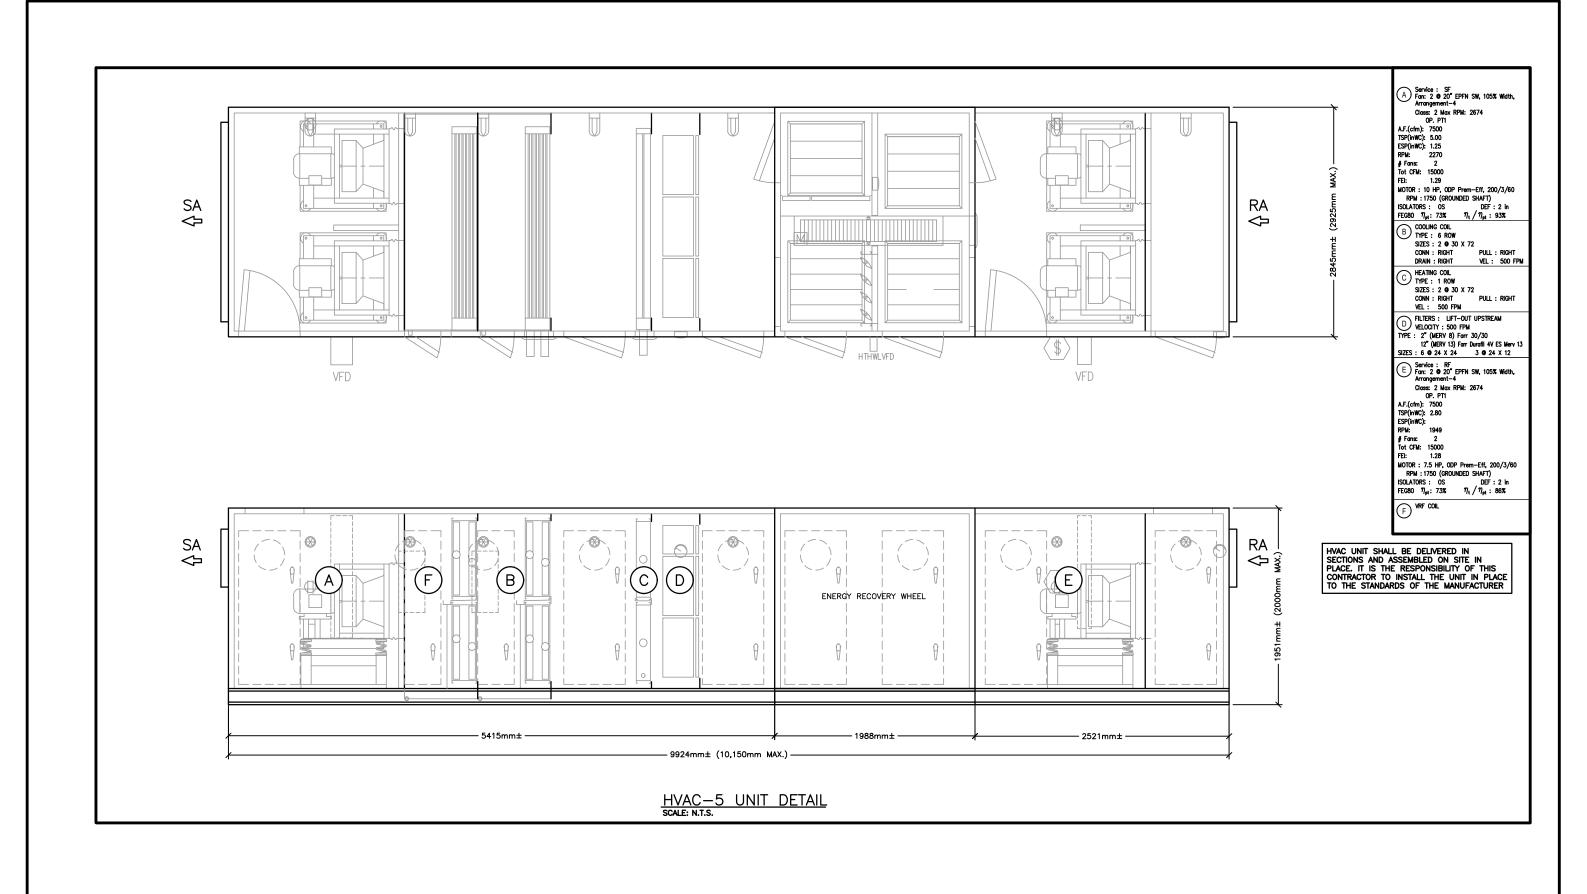



	Description		Elec	trical Da	ta			Starter			(Ctrl Device	e	l:	solating	Device						I	Remote	Items						Ot	Other	Interlo	ck								
Mechanical Item	Description	Provided By Voltage	Size hp/kW/Amps		Phase MOCP	Magnetic	Manual	Combination Contactor	VFD	ECM (No Separate Starter Device)	Hand/Off/Auto	On/Off Selector High/Low/Off	Pilot Light	Disconnect	WP Disconnect	Breaker/Fuse	Starter/Device Wired by	RA Thermostat	Programmable Time Clock	Variable Speed Control	Current Sensor	Occ Sensor	Dual Voltage Relay	Interval Timer	VRF System Controll Panel	Smoke Control System Panel Control Panel	Wired by	Bldg Auto System	Wired By	Miscellaneous 1	Miscellaneous 2	Interlock to		Interlock by				Remarks			
SE 1																																		PHAS	SE 1						
5	ROOFTOP EXHAUST FAN (CHEMISTRY A212)	M 120) 1/4 F	IP	1							E			Е	Е	Е						M				M/E	М	М			MOT. DAMPE	≣R	M PRO	VIDE INDIC	ATING LIGH	IT. INTERLO	СК ТО МОТС	RIZED DAMPE	R	
6	ROOFTOP EXHAUST FAN (BIOLOGY A211)	M 120) 1/4 H	IP	1							E			E	E	Е						M				M/E	М	М			MOT. DAMPE	ΞR	M PRO	VIDE INDIC	ATING LIGH	IT. INTERLO	СК ТО МОТС	RIZED DAMPE	R	
7	ROOFTOP EXHAUST FAN (CHEMISTRY A212 FUME HOOD)	M 208	3/4 F	IP	3	E						E			Е	Е	Е										M/E	М	М		F	IME HOOD & MOT.	. DAMPER	M/E CON	INECT TO S	WITCH ON F	FUME HOOI). INTERLOC	K TO MOTORI	ED DAMPER	
	ELEVATOR SUMP (SIMPLEX)	M 208	3 0.5 H	IP	3									E		Е	Е									М	M/E							PRO	VIDE RECE	PTACLE FO	R HIGH LEV	EL ALARM. V	VIRE FLOATS 1	HROUGH CONT	ROL PANE
3	DELETED																																								
3	DELETED																																								
	GAS SOLENOID VALVE	M 120) FHI	o	1											Е	Е						М				M/E	М	М					REF	ER TO PLAI	NS FOR NUM	MBER & LOC	CATIONS			
3	BAS PANEL	M 120) FHI	0	1									E		Е	Е											М	М					PRO	VIDE TWO	DATA DROP	S AND REC	EPTACLE. R	EFER TO PLAN	S FOR NUMBER	& LOCATI
	ACID NEUTRALIZING TANK	M 120) FHI	0	1									E		E	Е																	PRO	VIDE RECE	PTACLE					
3	ELEVATOR MACHINE ROOM EXHAUST	M 120) 1/4 H	IP	1									Е		Е	Е	E					М				M/E														
2				V V		\\\\\\\\\\\\\\\\\\\\\\\\\\\\\\\\\\\\\\								\\\\\\\\\\\\\\\\\\\\\\\\\\\\\\\\\\\\\\	\\\\\\\\\\\\\\\\\\\\\\\\\\\\\\\\\\\\\\		~~~	~~~	~	~		\\	~	\\\\\\\\\\\\\\\\\\\\\\\\\\\\\\\\\\\\\\	\\\\\\\\\\\\\\\\\\\\\\\\\\\\\\\\\\\\\\			~~	~	~~		~~~~~~~~~~~~~~~~~~~~~~~~~~~~~~~~~~~~~~	\\\\\\\\\\\\\\\\\\\\\\\\\\\\\\\\\\\\\\		\sim		\\\\\\\\\\\\\\\\\\\\\\\\\\\\\\\\\\\\\\		~~~	~~~~~~~~~~~~~~~~~~~~~~~~~~~~~~~~~~~~~~	
	INDOOR HVAC UNIT		3 118 AI		3 125				М					E		E	Е					,							М			CU-3A CU-3		JUNG	CTION BOX	. VFD INSTA	ALL AND PC	WER CONNE	CTION BY ELE	ORY PROVIDED	ON
.1	CONDENSING UNIT	M 208	61.9		3 70										E	E	E											\checkmark	M			HVAC-5		CU-3	BA IS TWO I	MODULES. F	REFER TO F	PLANS FOR N	UMBER & LOC	ATIONS.	
2	CONDENSING UNIT	M 208	61.9	Α	3 70										E	Е	Е											М	М			HVAC-5		CU-3	BA IS TWO N	MODULES. F	REFER TO F	PLANS FOR N	UMBER & LOC	ATIONS.	
31	CONDENSING UNIT	M 208	61.9	A	3 70										E	Е	E											М	М			HVAC-5		CU-3	BB IS TWO N	MODULES. F	REFER TO F	PLANS FOR N	UMBER & LOC	ATIONS.	
32	CONDENSING UNIT	M 208	61.9	A	3 70										Е	E	Е											М	М			HVAC-5		CU-3	BB IS TWO N	MODULES. F	REFER TO F	PLANS FOR N	UMBER & LOC	ATIONS.	
	BRANCH SELECTOR BOX	M 208	3 0.4	A	1									E		E	Е											М	М			HVAC-5, CU-3A, (CU-3B	REF! OF B	ER TO PLAI BRANCH BC	NS FOR NUM EXES FOR EA	MBER & LOC ACH CONDE	CATIONS. PR	OVIDE SEPAR	ATE CIRCUIT FO	R EACH SE
	CU CONTROL BOX	M 208	3 0.3	A	1									E		Е	Е											М	М			CU-3A CU-3	В	REF	ER TO PLAI	NS FOR NUM	MBER & LOC	CATIONS			
0	HVAC-5 HEATING COIL CIRCULATION PUM	P M 208	3 0.5 H	IP	3			E			E		E	Е		E	E											М	М												

PROVIDE MAIN FEED TO UNIT. PROVIDE ADDITIONAL FEED FROM TERMINAL STRIPS WITHIN UNIT TO VARIABLE FREQUENCY DRIVE AND BACK TO UNIT (IN SEPARATE CONDUITS). COORDINATE CONDUCTOR SIZE TO AND FROM VARIABLE FREQUENCY DRIVE WITH MECHANICAL SHOP DRAWINGS.

The contractor shall verify all dimensions and report all errors and discrepancies to the Consultant before commencement of the work.

The drawings show general arrangement of services. Follow as closely as actual building construction will permit. Obtain approval for relocation of service from Consultant before commencement of the work.

The drawings do not indicate all offsets fitting and accessories which may be required. Provide the same to meet the required conditions.

Drawings and specifications, etc., prepared and issued by the Consultant are the property of the Consultant and must be returned at the completion of the project. These documents are not to be duplicated or copied without the consent of the Consultant.

Do not scale this drawing.

© 2025 DEI Consulting Engineers Inc.

E = ELECTRICAL



No.	revisions	DATE
1	ISSUED FOR 50% PROGRESS	2024.01.14
2	ISSUED FOR 75% REVIEW	2025.01.31
4	ISSUED FOR PERMIT/TENDER	2025.03.05
5	ISSUED FOR ADDENDUM 01	2025.03.20
6	ISSUED FOR ADDENDUM 02	2025.03.24
7	ISSUED FOR ADDENDUM 03	2025.04.01
-		
-		

CHRONOLOGY DATE







PROJECT NAME

GLENVIEW PARK
SECONDARY SCHOOL
HVAC IMPROVEMENTS

55 McKay St., Cambridge, ON, N1R 4G8

AWING TITLE

EQUIPMENT WIRING SCHEDULE


DRAWING NUMBER

HEET SIZE 24X36


24162

PROJECT NUMBER

E103

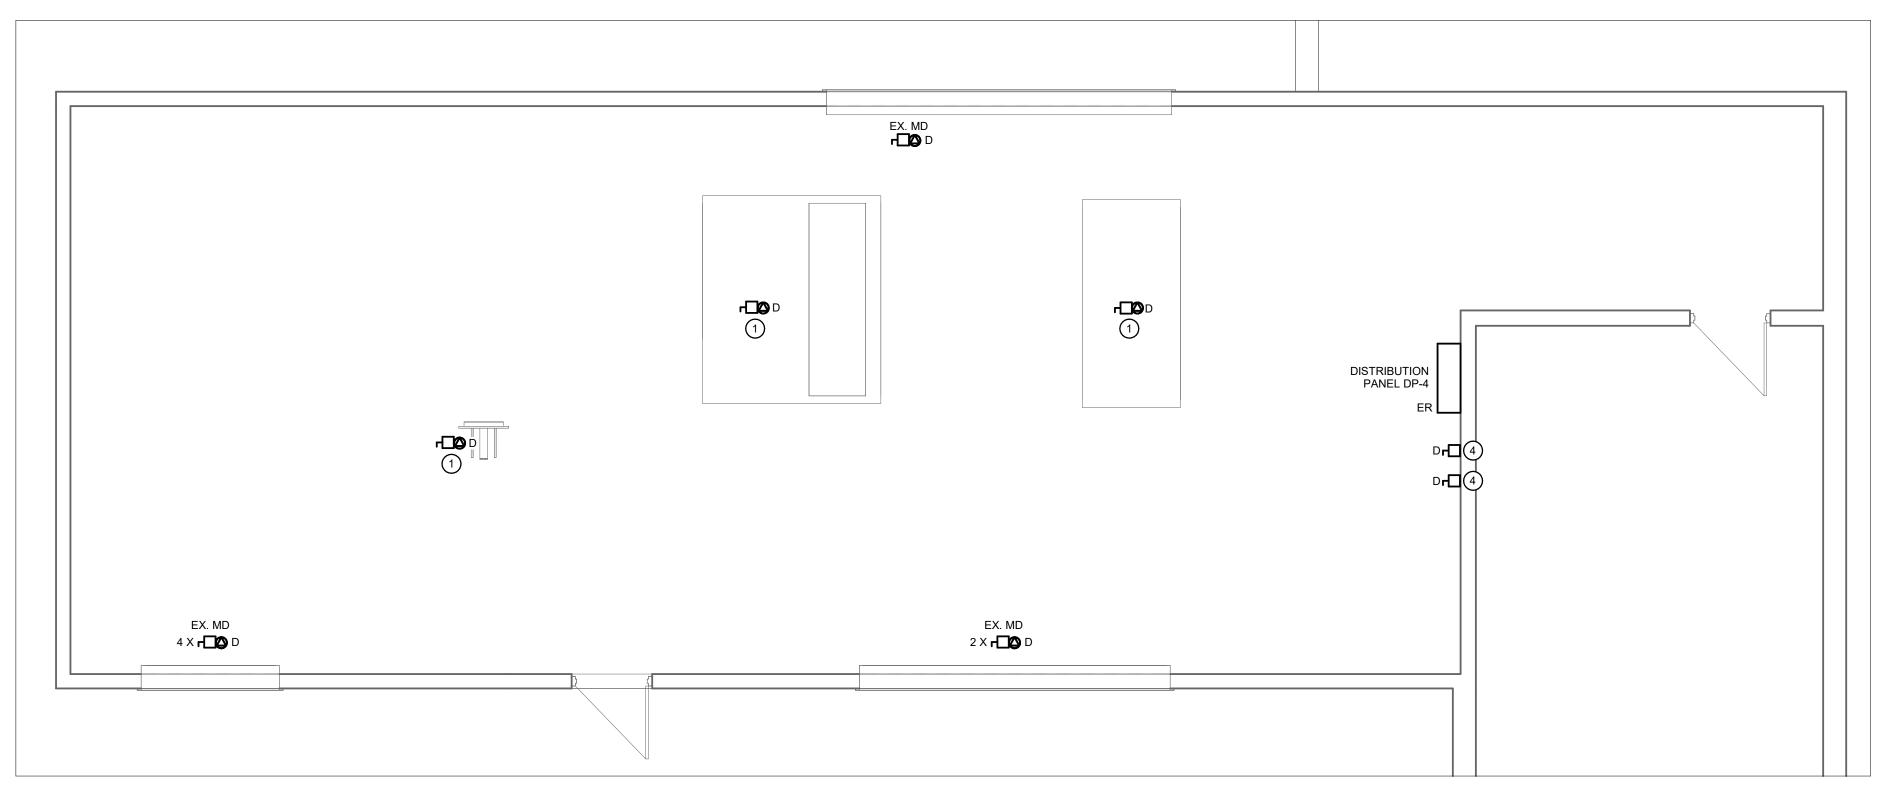

A - ROOF - MECHANICAL ROOM - POWER & SYSTEMS - DEMOLITION PLAN SCALE: 1:50

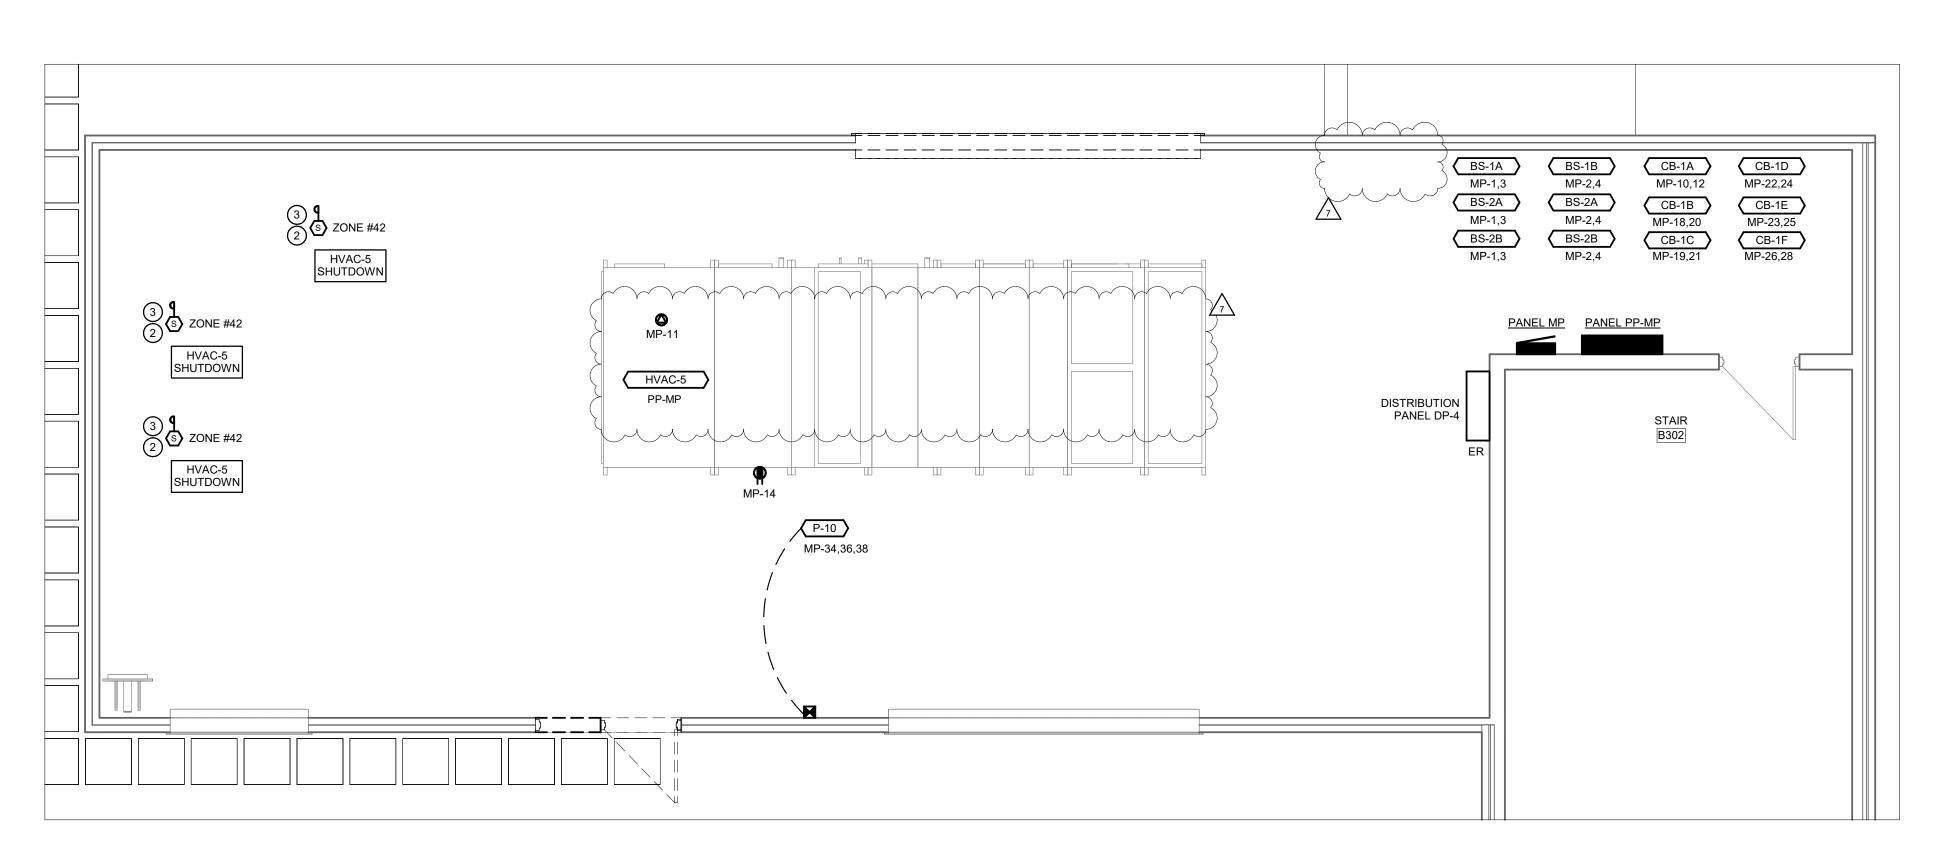

B - ROOF - MECHANICAL ROOM - POWER & SYSTEMS - RENOVATION PLAN
SCALE: 1:50

GENERAL NOTES - DEMOLITION

- 'ER' INDICATES EXISTING ITEM TO REMAIN.
- EXISTING ELECTRICAL EQUIPMENT NOT SHOWN SHALL REMAIN UNLESS NOTED OTHERWISE.
- 'R' INDICATES EXISTING ITEM TO BE RELOCATED. REFER TO RENOVATION DRAWINGS AND RELOCATE DEVICE AND WIRING TO SUIT. UNLESS OTHERWISE NOTED. 'D' INDICATES EXISTING ITEM TO BE DEMOLISHED. UNLESS
- OTHERWISE NOTED DISCONNECT AND REMOVE NOTED DEVICE AND WIRING BACK TO SOURCE. ALL LIGHTING FIXTURES BEING RELOCATED SHALL BE
- CLEANED AND CHECKED PRIOR TO BEING REINSTALLED.

GENERAL NOTES - RENOVATION

- 'ER' INDICATES EXISTING ITEM TO REMAIN. 'R' INDICATES EXISTING ITEM IN RELOCATED POSITION.
- ALL DEVICES SHOWN ARE NEW UNLESS OTHERWISE EXISTING ELECTRICAL EQUIPMENT NOT SHOWN SHALL
- MAINTAIN SERVICE TO ALL EXISTING DEVICES TO REMAIN. REVISE PANEL DIRECTORIES TO SUIT CHANGES (TYPED).

REMAIN UNLESS OTHERWISE NOTED.

SPECIFIC NOTES

- INDICATES EXISTING FAN UNIT TO BE REMOVED COMPLETE BY MECHANICAL CONTRACTOR. ELECTRICAL CONTRACTOR SHALL REMOVE EXISTING CONDUIT AND WIRING BACK TO SOURCE PANEL AND MAKE SAFE. MARK BREAKER AS SPARE.
- INDICATES DUCT TYPE SMOKE DETECTOR MOUNTED IN STRAIGHT SECTION OF SUPPLY DUCT OF MECHANICAL DUCT. REFER TO MECHANICAL DRAWINGS FOR PROPOSED DUCT LOCATIONS AND FURTHER DETAILS. COORDINATE EXACT LOCATION TO INSTALL DUCT SMOKE DETECTOR WITH DUCT STRUCTURE AND ACCESSORIES (SILENCERS) FOR SUITABLE RUN. CONFIRM LOCATION, DETAILS AND REQUIREMENTS WITH THE FIRE ALARM MANUFACTURER AND MECHANICAL CONTRACTOR. CONNECT NEW FIRE ALARM INITIATING DEVICE TO
- EXISTING LOCAL INITIATING CIRCUIT.RE-VERIFY PORTIONS OF ALARM SYSTEM TO CAN/ULC-S537. REFER TO SPECIFICATIONS FOR FURTHER DETAILS AND REQUIREMENTS.
- INDICATES EXISTING EXHAUST FAN DISCONNECT SWITCH TO BE REMOVED AS PART OF THIS SCOPE OF WORK. COORDINATE EXACT LOCATION AND DETAILS WITH MECHANICAL CONTRACTOR.

The drawings show general arrangement of services.
Follow as closely as actual building construction will permit. Obtain approval for relocation of service from Consultant before commencement of the work. The drawings do not indicate all offsets fitting and accessories which may be required. Provide the same to meet the required conditions. Drawings and specifications, etc., prepared and issued

commencement of the work.

by the Consultant are the property of the Consultant and must be returned at the completion of the project. These documents are not to be duplicated or copied without the consent of the Consultant. Do not scale this drawing.
© 2025 DEI Consulting Engineers Inc.

The contractor shall verify all dimensions and report all errors and discrepancies to the Consultant before



No.	REVISIONS	DATE
2	ISSUED FOR 75% REVIEW	2025.01.31
4	ISSUED FOR PERMIT/TENDER	2025.03.05
5	ISSUED FOR ADDENDUM 01	2025.03.20
7	ISSUED FOR ADDENDUM 03	2025.04.01

CHRONOLOGY	DATE







GLENVIEW PARK SECONDARY SCHOOL HVAC IMPROVEMENTS 55 McKay St., Cambridge, ON, N1R 4G8


ENLARGED PLANS (4 OF 4)

1:50

DRAWING NUMBER

E304

PROJECT NUMBER 24162

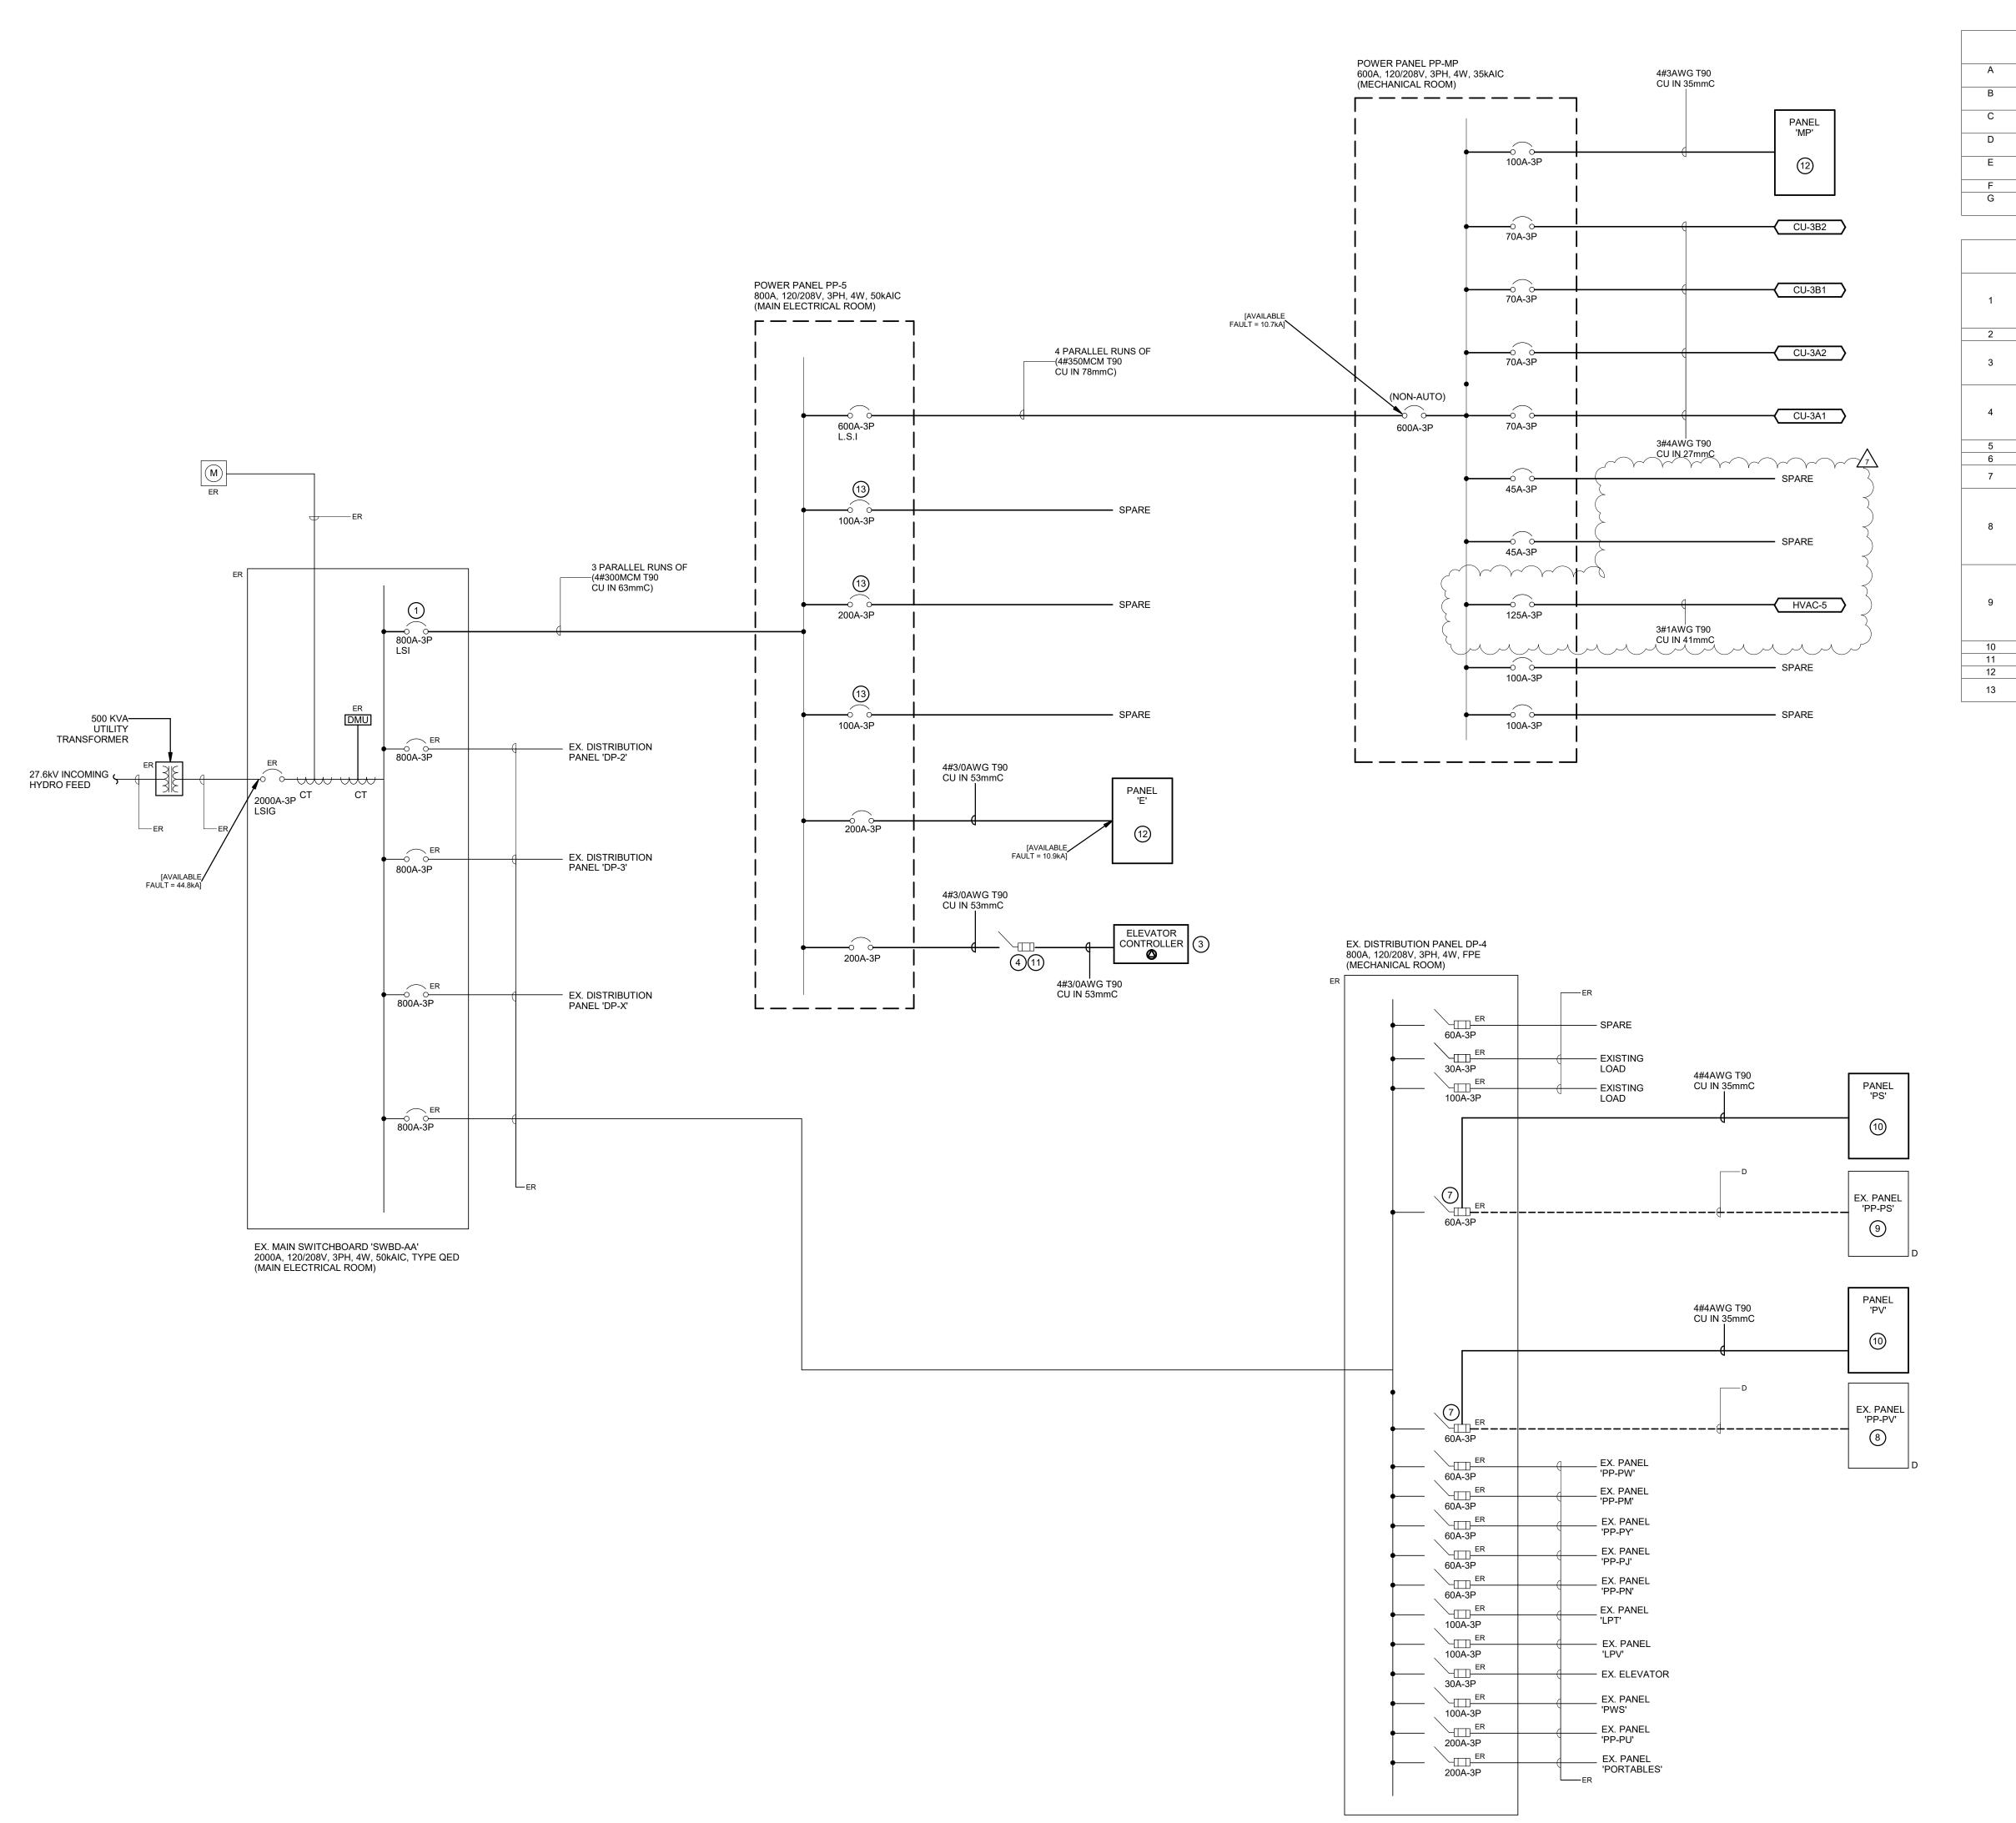

GENERAL NOTES - DISTRIBUTION RISER

- A RISER IS DIAGRAMMATIC ONLY. REFER TO FLOOR PLANS FOR LOCATION OF ALL DISTRIBUTION EQUIPMENT AND FURTHER REQUIREMENTS.
- REFER TO SPECIFICATIONS FOR FURTHER INFORMATION REGARDING MOULDED CASE CIRCUIT BREAKERS.
- PROVIDE GROUND WIRE IN ALL BRANCH CIRCUITS AND FEEDERS TO SUIT THE ONTARIO
- ELECTRICAL SAFETY CODE. ALL LIGHTING CIRCUITS SHALL BE PROVIDED WITH SEPARATE NEUTRALS. SIZE BRANCH
- CONDUITS ACCORDINGLY. ALL DISTRIBUTION EQUIPMENT SHALL BE PROVIDED WITH WARNING LABELS CONFORMING
- TO THE ONTARIO ELECTRICAL SAFETY CODE RULE #2-306(1)(2). REFER TO PANEL SCHEDULES FOR QUANTITY OF CIRCUITS AND FURTHER DETAILS.
- ALL CONDUCTORS FOR THE FIRE ALARM SYSTEM SHALL BE INSTALLED IN A SEPARATE ENCLOSED CONDUIT SYSTEM.

SPECIFIC NOTES

- PROVIDE NEW BREAKER INDICATED C/W NEW REQUIRED MOUNTING HARDWARE TO ACCOMMODATE WIRE SIZE INDICATED. PROCURE FOR THE SERVICES OF SCHNEIDER FIELD SERVICES GROUP TO REWORK, MODIFY AND RECERTIFY PANEL BUS AS REQUIRED TO FACILITATE INSTALLATION OF NEW BREAKER PROVIDED AS PART OF THIS SCOPE OF NOT USED.
- CONNECTIONS TO THE LINE SIDE OF ELEVATOR CONTROL PANEL SHALL BE UNDER THE DIRECT GUIDANCE OF THE ELEVATOR CONTRACTOR. CONFIRM ALL POWER, DISCONNECT SWITCH AND CONTROL WIRING REQUIREMENTS WITH ELEVATOR SHOP DRAWINGS PRIOR TO PROCURING AND INSTALLING ELECTRICAL REQUIREMENTS. DISCONNECT SWITCH INDICATED FOR ELEVATOR CONTROL PANEL MUST BE LOCKABLE (I.E.
- EQUIPPED WITH MEANS FOR LOCKING IT IN THE OPEN POSITION). PROVIDE TWO (2) SETS OF ELEVATOR RATED AUXILIARY CONTACTS TO SUIT THE ELEVATOR CONTRACTOR.

 COORDINATE EXACT LOCATION TO MOUNT DISCONNECT SWITCH ON SITE WITH ELEVATOR CONTRACTOR. NOT USED.
- NOT USED.
- PROVIDE NEW 60A-3P FUSES IN EXISTING 60A-3P FUSIBLE DISCONNECT SWITCH INDICATED.
- CONTRACTOR SHALL SWING OVER TEN (10) EXISTING CIRCUITS AS REQUIRED FROM PANEL PP-PV TO NEW PANEL PV PROVIDED AS PART OF THIS SCOPE OF WORK TO MAINTAIN EXISTING SERVICES. REFER TO RENOVATION PLAN FOR LOCATION OF NEW PANEL. EXISTING TO REMAIN SERVICES TO BE IDENTIFIED DURING CONSTRUCTION AND ARE NOT SHOWN ON THE DRAWINGS. PROVIDE NEW BREAKERS AND EXTEND EXISTING CONDUIT AND WIRE FEEDING EXISTING BRANCH DEVICES AND TIE INTO RESPECTIVE CIRCUITS
- CONTRACTOR SHALL SWING OVER TEN (10) EXISTING CIRCUITS AS REQUIRED FROM PANEL PP-PS TO NEW PANEL PS PROVIDED AS PART OF THIS SCOPE OF WORK TO MAINTAIN EXISTING SERVICES. REFER TO RENOVATION PLAN FOR LOCATION OF NEW PANEL. EXISTING TO REMAIN SERVICES TO BE IDENTIFIED DURING CONSTRUCTION AND ARE NOT SHOWN ON THE DRAWINGS. PROVIDE NEW BREAKERS AND EXTEND EXISTING CONDUIT AND WIRE FEEDING EXISTING BRANCH DEVICES AND TIE INTO RESPECTIVE CIRCUITS
- INDICATES RECEPTACLE PANEL 120/208V, 3PH/4W, 100A MAINS, 10KAIC INDICATES 208V 3 PHASE 200A DISCONNECT SWITCH C/W 150A CLASS D FUSES.
- INDICATES RECEPTACLE PANEL 120/208V, 3PH/4W, 225A MAINS, 25KAIC INDICATES PREPARED SPACE FOR FUTURE BREAKER. PROVIDE ALL REQUIRED MOUNTING HARDWARE AND ACCESSORIES.

RELOCATED TO NEW PANEL PV.

RELOCATED TO NEW PANEL PS.

The contractor shall verify all dimensions and report all errors and discrepancies to the Consultant before commencement of the work. The drawings show general arrangement of services.
Follow as closely as actual building construction will permit. Obtain approval for relocation of service from Consultant before commencement of the work. The drawings do not indicate all offsets fitting and accessories which may be required. Provide the same to meet the required conditions.


Drawings and specifications, etc., prepared and issued by the Consultant are the property of the Consultant and must be returned at the completion of the project. These documents are not to be duplicated or copied without the consent of the Consultant.

Do not scale this drawing.

© 2025 DEI Consulting Engineers Inc.



No.	REVISIONS	DATE
1	ISSUED FOR 50% PROGRESS	2024.01.14
2	ISSUED FOR 75% REVIEW	2025.01.31
4	ISSUED FOR PERMIT/TENDER	2025.03.05
5	ISSUED FOR ADDENDUM 01	2025.03.20
6	ISSUED FOR ADDENDUM 02	2025.03.24
7	ISSUED FOR ADDENDUM 03	2025.04.01

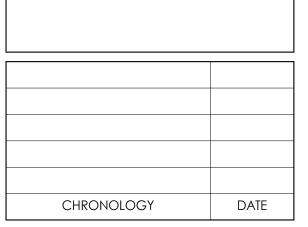







GLENVIEW PARK SECONDARY SCHOOL **HVAC IMPROVEMENTS** 55 McKay St., Cambridge, ON, N1R 4G8

DISTRIBUTION RISER DIAGRAM -RENOVATION

DRAWING NUMBER

SHEET SIZE

E401 PROJECT NUMBER 24162

	MAINS: 225 A	,	VOLTA	GE : 120	0/208	V 3F	PH4W		INTER	RRUPTING CAPACITY: 25 KAIC	
	MOUNTING: SURFACE	NEUT	ral bi	JS : 100	0%					ENCLOSURE: TYPE 2	
СКТ	Load Name	Туре	Rating	Poles	AE	ВС	Poles	Rating	Туре	Load Name	CK
1	ELEV. MACHINE RM LIGHTING		15 A	1			1	15 A		ELEVATOR PIT LIGHTING	2
3	ELEV MACHINE RM RECEPTACLE		20 A	1			1	20 A		ELEVATOR PIT / SHAFT RECEPTACLES	4
5							1	15 A		ELEVATOR CAB LIGHTING	6
7							1	15 A		ELEVATOR CAB COMMUNICATION	8
9							1	15 A		TANK COOLER	10
1	SUMP PUMP CONTROL PANEL		15 A	1							12
3	SUMP PUMP ALARM RECEPTACLE		15 A	1			3	15 A		SUMP PUMP (SP-1)	14
15	DOOR OPERATOR LEVEL 1 STAIR		15 A	1							16
17	DOOR HOLD OPEN		15 A	1			1	20 A		NEUTRALIZING TANK RECEPTACLE A118	18
19	FIRE SMOKE DAMPER - RM A205		15 A	1			1	15 A		FIRE SMOKE DAMPER - ELEVATOR WING	20
21	EXHAUST FAN (EF-8)		15 A	1							22
:3											24
25											26
27											28
9											30
1											32
3											34
55											36
37											38
9											40
1											42
3											44
5											46
7											48
.9											50
51											52
53											54
55	SPARE		15 A	1			1	20 A		SPARE	56
57	SPARE		15 A	1			1	20 A		SPARE	58
59	SPARE		15 A	1			1	20 A		SPARE	60

	MAINS: 100 A		VOLTA			8V (3PF	H4W		INTER	RRUPTING CAPACITY: 10 KAIC	
	MOUNTING: SURFACE	NEUI	ral bi	JS : 10	υ‰						ENCLOSURE: TYPE 2	
СКТ	Load Name	Туре	Rating	Poles	Α	В	C F	Poles	Rating	Туре	Load Name	CK
1	WORKBENCH RECEPTACLES		20 A	1				1	20 A		WORKBENCH RECEPTACLES	2
3	WORKBENCH RECEPTACLES		20 A	1				1	20 A		WORKBENCH RECEPTACLES	4
5	WORKBENCH RECEPTACLES		20 A	1				1	20 A		WORKBENCH RECEPTACLES	6
7	WORKBENCH RECEPTACLES		20 A	1				1	20 A		WORKBENCH RECEPTACLES	8
9	WALL RECEPTACLES		15 A	1				1	15 A		GAS SOLENOID VALVE	10
11	CEILING RECEPTACLE		15 A	1				1	15 A		BAS PANEL	12
13	EXISTING BRANCH CIRCUIT		15 A	1				1	15 A		EXISTING BRANCH CIRCUIT	14
15	EXISTING BRANCH CIRCUIT		15 A	1				1	15 A		EXISTING BRANCH CIRCUIT	16
17	EXISTING BRANCH CIRCUIT		15 A	1				1	15 A		EXISTING BRANCH CIRCUIT	18
19	EXISTING BRANCH CIRCUIT		15 A	1				1	15 A		EXISTING BRANCH CIRCUIT	20
21	EXISTING BRANCH CIRCUIT		15 A	1				1	15 A		EXISTING BRANCH CIRCUIT	22
23	FIRE SMOKE DAMPER		15 A	1								24
25												26
27												28
29												30
31												32
33												34
35												36
37	SPARE		20 A	1				1	15 A		SPARE	38
39	SPARE		20 A	1			T	1	15 A		SPARE	40
41	SPARE		20 A	1				1	15 A		SPARE	42

	MAINS: 100 A MOUNTING: SURFACE		VOLTAG			8V :	3PI	H4W		INTER	RRUPTING CAPACITY: 10 KAIC ENCLOSURE: TYPE 2	
СКТ	Load Name	Туре	Rating	Poles	Α	В	С	Poles	Rating	Туре	Load Name	CK
1	WORKBENCH RECEPTACLES		20 A	1				1	20 A		WORKBENCH RECEPTACLES	2
3	WORKBENCH RECEPTACLES		20 A	1				1	20 A		WORKBENCH RECEPTACLES	4
5	WORKBENCH RECEPTACLES		20 A	1				1	20 A		WORKBENCH RECEPTACLES	6
7	WORKBENCH RECEPTACLES		20 A	1				1	20 A		WORKBENCH RECEPTACLES	8
9	WORKBENCH RECEPTACLES		20 A	1				1	20 A		WORKBENCH RECEPTACLES	10
11	WALL RECEPTACLES		15 A	1				1	15 A		CEILING RECEPTACLE	12
13	GAS SOLENOID VALVE		15 A	1				1	15 A		EXISTING BRANCH CIRCUIT	14
15	EXISTING BRANCH CIRCUIT		15 A	1				1	15 A		EXISTING BRANCH CIRCUIT	16
17	EXISTING BRANCH CIRCUIT		15 A	1				1	15 A		EXISTING BRANCH CIRCUIT	18
19	EXISTING BRANCH CIRCUIT		15 A	1				1	15 A		EXISTING BRANCH CIRCUIT	20
21	EXISTING BRANCH CIRCUIT		15 A	1				1	15 A		EXISTING BRANCH CIRCUIT	22
23	EXISTING BRANCH CIRCUIT		15 A	1				1	15 A		FIRE SMOKE DAMPER	24
25												26
27												28
29												30
31												32
33												34
35												36
37	SPARE		15 A	1				1	20 A		SPARE	38
39	SPARE		15 A	1				1	20 A		SPARE	40
41	SPARE		15 A	1				1	20 A		SPARE	42

	MAINS: 225 A MOUNTING: SURFACE		VOLTAG				PH4W		INTER	RRUPTING CAPACITY: 25 KAIC ENCLOSURE: TYPE 2	
СКТ	Load Name	Туре	Rating	Poles	A	ВС	Poles	Rating	Туре	Load Name	СКТ
3	BRANCH SELECTOR CU-4A		15 A	2			2	15 A		BRANCH SELECTOR CU-4B	2
5	ROOF MAINTENANCE RECEPTACLE		20 A	1			1	15 A		ROOF EXHAUST FAN (EF-6)	6
7	ROOF MAINTENANCE RECEPTACLE		20 A	1			1	15 A		ROOF EXHAUST FAN (EF-5)	8
.9	ROOF MAINTENANCE RECEPTACLE		20-A	1/	$\overline{}$						10
11	MARINE LIGHTS	Y	15 A	1	1	2	2	15 A		CONTROL BOX CB	12
13							1	20 A		MECH. ROOM RECEPTACLE	14
15											16
17							_				18
19		~			1		2	15 A		CONTROL BOX CB	20
21	CONTROL BOX CB		15 A	2			_				22
23				_			2	15 A		CONTROL BOX CB	24
25	CONTROL BOX CB		15 A	2							26
27				_			2	15 A		CONTROL BOX CB	28
29	MECHANICAL PIPE HEAT TRACING	GFI	20 A	2							30
31	MESUANUSAL BIBE HEAT TRANSILO	051	00.4				2	20 A	GFI	MECHANICAL PIPE HEAT TRACING	32
33	MECHANICAL PIPE HEAT TRACING	GFI	20 A	2							34
35							3	15 A		HVAC-5 CIRCULATION PUMP (P-10)	36
37	ROOF EXHAUST FAN (EF-7)		15 A	3							38
39											40
11											42
13											44
15											46
17											48
19											50
51											52
53											54
55											56
57											58
59											60
61											62
3											64
55											66
67	SPARE		15 A	1			1	20 A		SPARE	68
69	SPARE		15 A	1			1	20 A		SPARE	70
71 OTES:	SPARE		15 A	1			1	20 A		SPARE	72

The contractor shall verify all dimensions and report all errors and discrepancies to the Consultant before commencement of the work.

The drawings show general arrangement of services. Follow as closely as actual building construction will permit. Obtain approval for relocation of service from Consultant before commencement of the work.

The drawings do not indicate all offsets fitting and accessories which may be required. Provide the same to meet the required conditions.

Drawings and specifications, etc., prepared and issued by the Consultant are the property of the Consultant and must be returned at the completion of the project. These documents are not to be duplicated or copied without the consent of the Consultant.

Do not scale this drawing.

© 2025 DEI Consulting Engineers Inc.



I	KEVISIONS	DATE
2	ISSUED FOR 75% REVIEW	2025.01.3
4	ISSUED FOR PERMIT/TENDER	2025.03.0
5	ISSUED FOR ADDENDUM 01	2025.03.2
6	ISSUED FOR ADDENDUM 02	2025.03.2
7	ISSUED FOR ADDENDUM 03	2025.04.0
	l .	1

	_		
CHRONOLOGY	DATE		







PROJECT NAME

GLENVIEW PARK
SECONDARY SCHOOL
HVAC IMPROVEMENTS

55 McKay St., Cambridge, ON, N1R 4G8

DRAWING TITLE

PANEL SCHEDULES

SCALE DRAWING NUMBER

SHEET SIZE

24X36

PROJECT NUMBER

24162

E402

2025-04-01 1:58:58 PM C:_Revit\24162 WRDSB Glenview Park SS Elec Central (RVT23)_aara